



ランニングコース		メインアリーナ収容		PS		試演室(会議)					
D181	88	Y233'	96	C401	2	D106'	18	サブアリーナ収容			
				機器庫		試演室(会議)		Y233'		42	
				C401G		1	D106	24			
						D933'		12			
収容		研修室		トレーニング室		スポーツカフェ		収容		ストレッチテニ	
E401	30	E401	30	E401	30	E401	15	E401	54	E401	15
E301	3	E201	3	E201	3	E201	3	E201	3	E301	3
E201	3										
</											

屋外機置場1	
X201WP	8
電気室	
B241	6
V201	5
屋下	
V201	7
機置場3	
B241	6
EPS	
C401	1

屋外機置場2	
X201WP	4

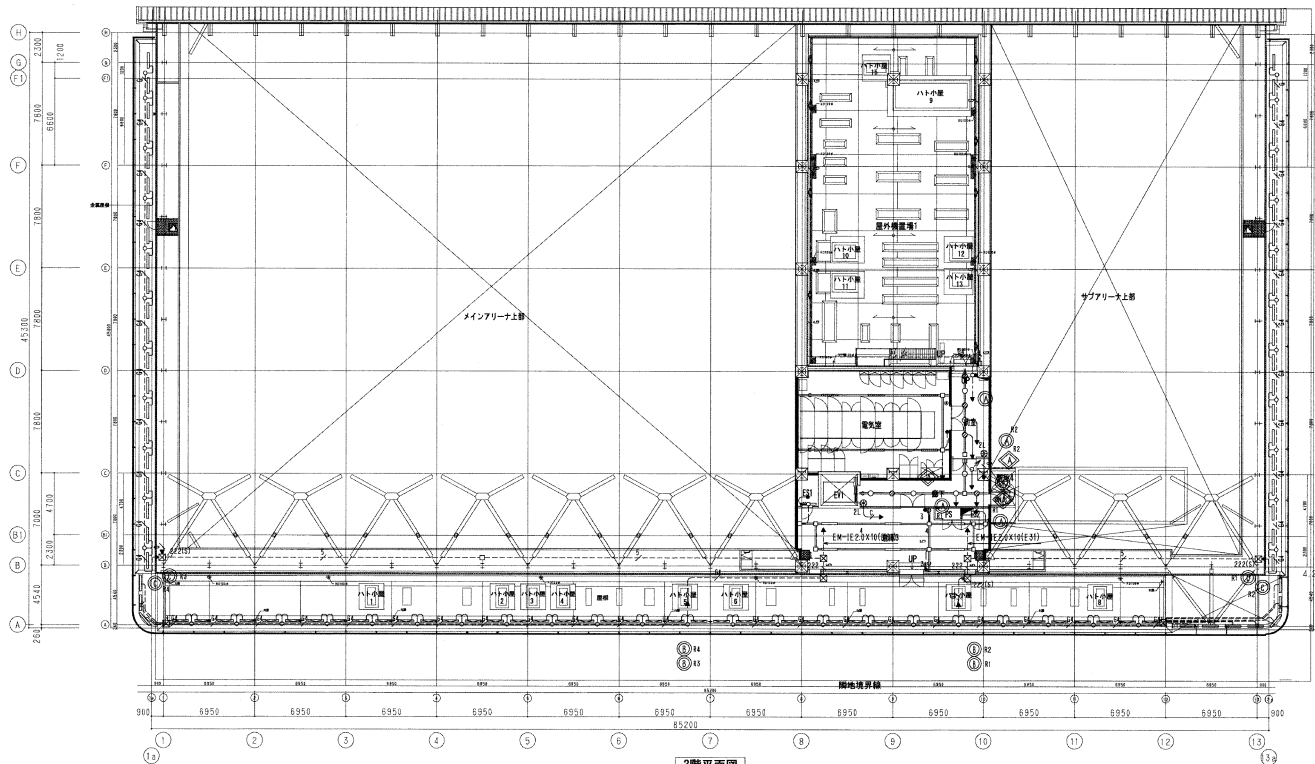

屋外	
n21'	44
n21	52

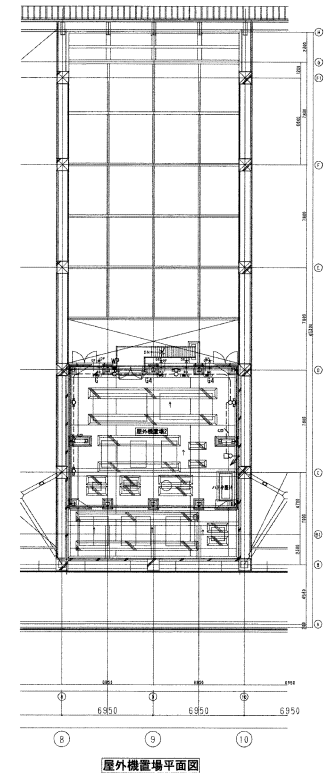

完成図

竣工 2017.3.31

確認 株式会社久米設計 監理総括者 梅田 幸一
株式会社久米設計 監理担当者 渡邊 正男
作成 株式会社熊谷組 現場代理人 遠藤 孝治

KUME
SEKKEI 株式会社 久米設計

2014.11.28

【設備関係図に適合することを確認した者】

設備設計一般建築士 建築士証交付番号 第2398号 横山大毅

1 般建築士 登録番号232895号 上田 克行

1 般建築士 登録番号276489号 藤森 慶弘

(仮称)門真市立総合体育館建設工事


電灯設備 3・R階平面図

A1階 1/200
A3階 1/400

1130223

E-28

图下1	
ca	5
ab	2

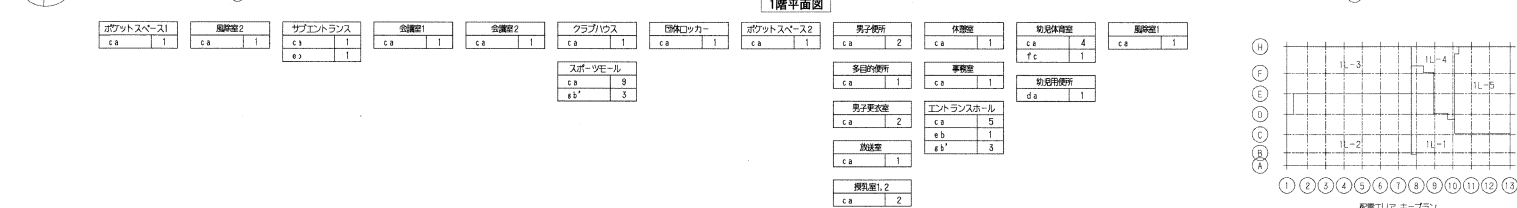

1. 図中の各記号には下記を示す

-----	天井吊钩固定金座
-----	吊钩固定金座
-----	吊钩固定金座
-----	ケーブルごうし金座

2. 図中の各記号には下記を示す

-----	EM-EI2.0X2(PF16)
-----	EM-EI2.0X3(PF16)
-----	EM-EI2.0X4(PF16)
-----	EM-CPE6.9-2P(PF16)
-----	EM-EI2.0X3(PF16)
-----	EM-CPE6.9-2P(PF16)
-----	EM-EF2.0-2C〔保護管(PF16)〕
-----	EM-EF2.0-3C〔保護管(PF16)〕
-----	EM-EF2.0-2C〔保護管(PF16)〕
-----	EM-CPE6.9-2P〔保護管(PF16)〕
-----	EM-EF2.0-3C〔保護管(PF16)〕
-----	EM-CPE6.9-2P〔保護管(PF16)〕
-----	EM-CPE6.9-2P〔保護管(PF16)〕
-----	EM-EI2.0X3(E19)
-----	EM-EI2.0X3(E19)
-----	EM-FP2.0-2C(PF16)
-----	EM-FP2.0-2C〔保護管(PF16)〕
-----	EM-EI2.0X3(E19)
-----	EM-FP2.0-2C(E19)
-----	EM-FP2.0-2C(40X30H)



3. 図中の下部の配管は電線管にて保護すること

4. 図中、吊钩固定金座は電線管の両端に設置すること

5. 図中の吊钩固定金座は電線管の両端に設置すること

ca	2
oa	1
ab'	2
bb'	1
fc	1


2L-4

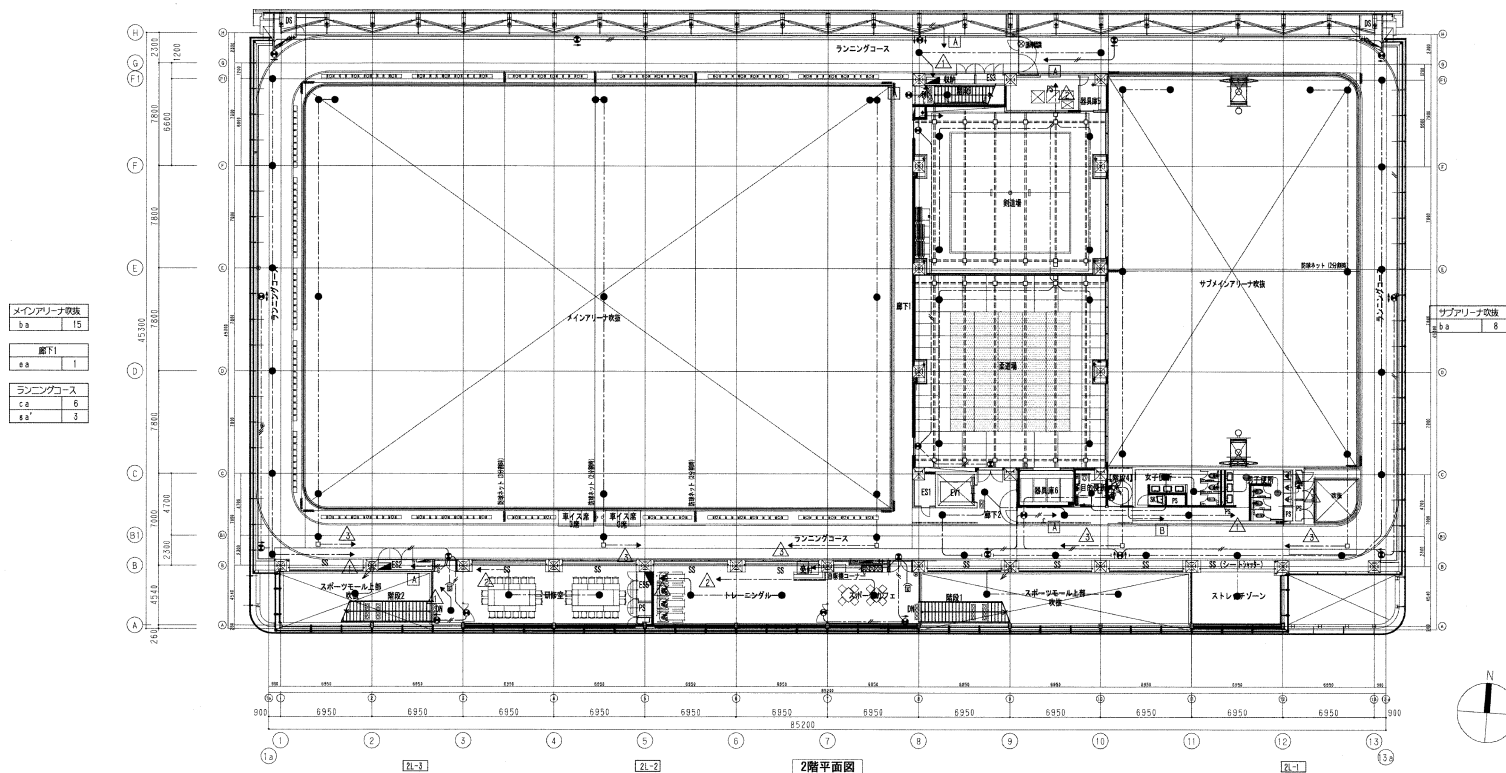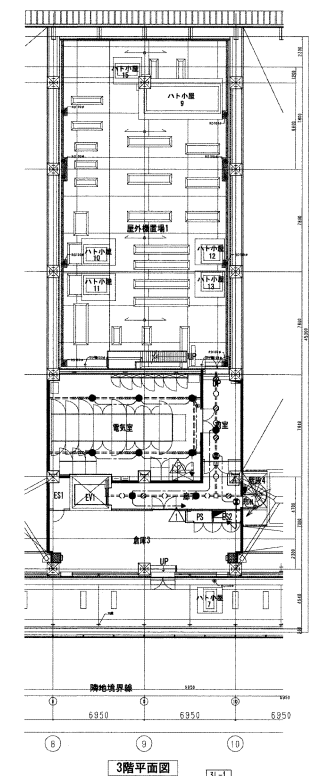

留下2		多目的使用		階段4		女子使用		男子使用	
ca	4	ca	1	ka	1	ca	2	ca	2
fc	1			fc	1				

ランニングコース	
c a	5
e a	2
a a'	1
a b'	1

吹 抜		通 路		研 究 室		ト レ ー ニ ン グ 室		ス ポ ー ツ カ フ ェ		吹 抜		ス ト レ ッ チ ゼ ー ン	
ba	1	ca	1	ca	2	ca	2	ca	1	ba	2	ca	1
		ga'	1	ff	1	ff	1	ca	1				
								ga'	1				

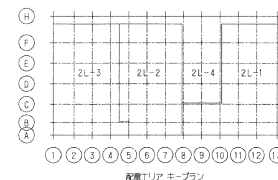

電氣屋	
da	6

前室	
da	1
fa	1

廊下	
da	2
fa	1

階段	
ja	1

E- 31

